


LEGEND :

- MANHOLE 80/80
- CONCRETE PIPE
- EXISTING DRAIN TO REMOVE

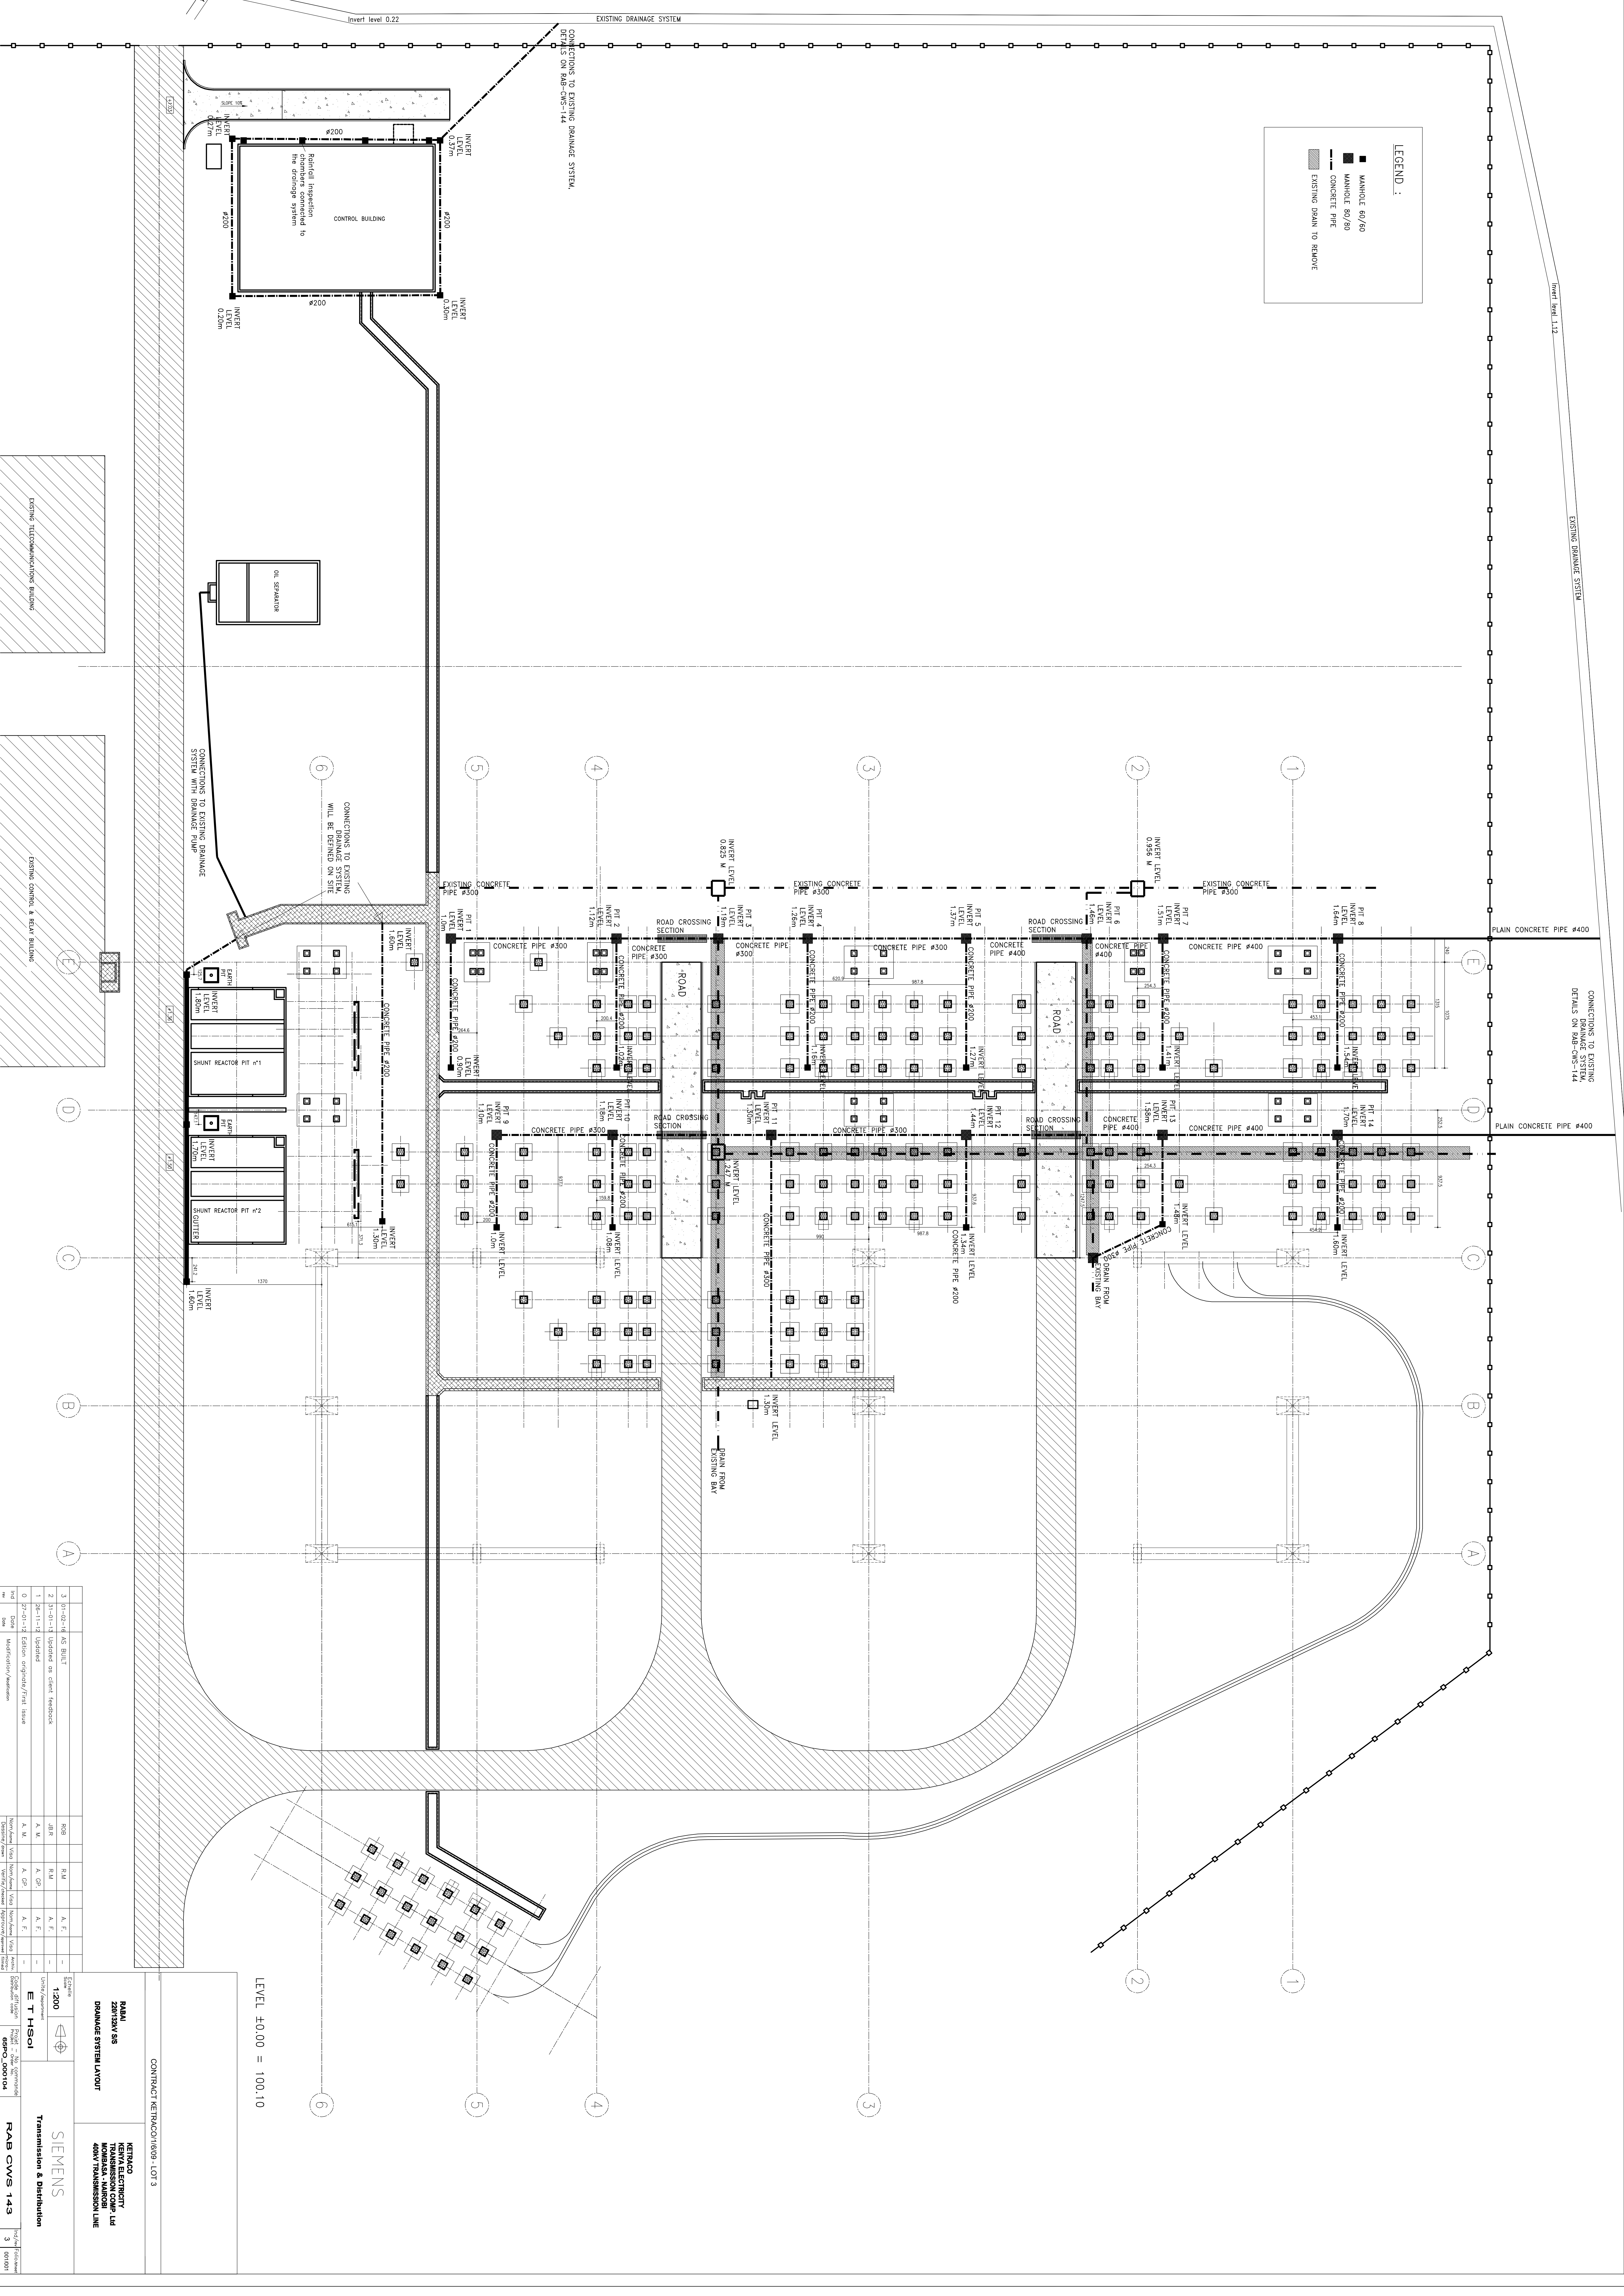

3	31-02-16 AS BUILT	ROB	R.H	A. F.	-
2	31-01-13 updated on client feedback	J.R	R.H	A. F.	-
1	26-11-12 updated	A. M.	R.H	A. F.	-
0	27-01-12 Edition original/first issue	A. M.	A. G.P	A. F.	-
Rev	Date	Author/Checker/Approver	Drawn/Checked/Verified	Reviewed/Approved	Project



DRAINAGE SYSTEM LAYOUT

SIEMENS

Transmission & Distribution

RAB CWS 143

3